

011222110

Address	[REDACTED]		
Owner		Issued	4-8-53
Plumber		Permit No.	100-42
Size and Type	4 Orangebung	Main	18
Date Connected		Inspected by	
Enters lot	38.7" E J W line		
Junction used	42.7		

Address	[REDACTED]		
Owner	[REDACTED]	Issued	7-1-68
Plumber	Koster	Permit No.	
Size and Type	4" CI	Main	18
Date Connected		Inspected by	
Enters lot	39' E/W line		
Junction used	Stub		


50322200

# HEALTH DEPT. SANITATION REPORT

M55997X

NAME: [REDACTED] NO. [REDACTED] DATE: 7/1/68  
 OPERATOR: KOSTER PLBG TYPE: [REDACTED] LICENSE: [REDACTED]

ADDRESS: [REDACTED] LOCATION: [REDACTED]  
 "C" 4" CAST IRON SEWER FROM 4" FIBER STUB  
 ADDRESS: GARAGE HOUSE TEL: [REDACTED]

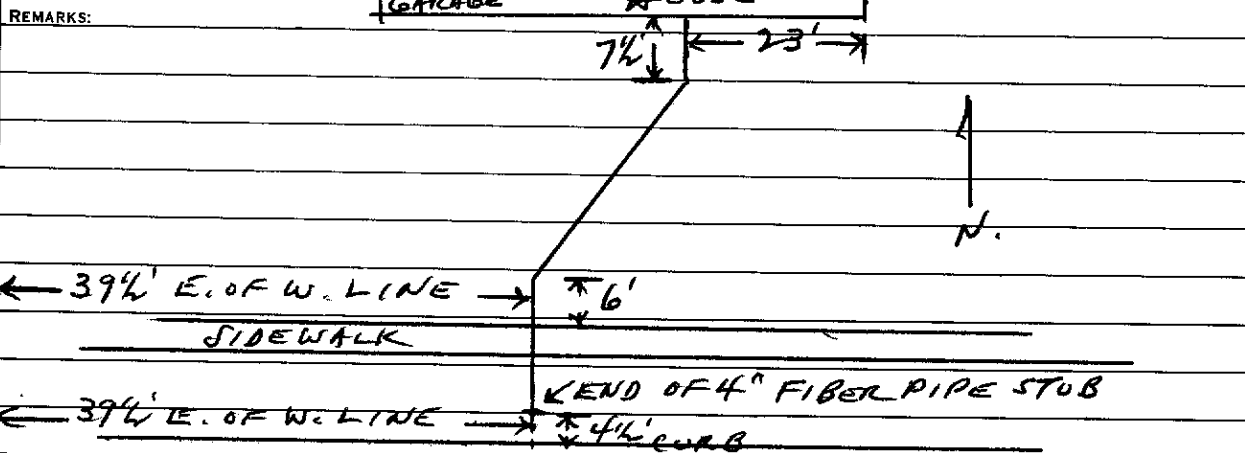

MICH. DEPT. OF HEALTH REPORT RECEIVED BY: W. 1878 JT REPRESENTATIVE  
 D65A

APPROVED	NOT APPROVED	BUILDING	HEAT-VENT	LIGHTING	SCREENING	SEATING	SAFETY	NUISANCE	WATER SUPPLY	BATHING	HAND WASHING	TOILETS	SEWAGE	REFUSE	GARBAGE	ANIMALS	VERMIN CONTROL	FOOD SOURCES	REFRIG-ERATION	DISH WASHING	UTENSILS	OTHER EQUIP.	PROC. & SERVING	STORING	PERSONNEL

(✓) INDICATES COMPLIANCE  
 (X) INDICATES NON-COMPLIANCE  
 (-) INDICATES ITEM DOES NOT APPLY